



Plug and play offices available in a well connected Grade A building

7 Bishopsgate

7-11 Bishopsgate, EC2N 3AR

Office

TO LET

5,813 to 20,804 sq ft

(540.05 to 1,932.75 sq m)

- New plug & play fit out installed on 3rd floor
- Electric sit / stand desks throughout
- Refurbished reception & manned
- VRF air conditioning / metal tile suspended ceiling
- New LED lighting / 2.7m + floor to ceiling height
- Bicycle racks and showers with tenant towel service
- Fully cabled for high speed fibre

Summary

Available Size	5,813 to 20,804 sq ft
Rent	£57.50 - £72.50 per sq ft pax
Rates Payable	£23 per sq ft est pa
Service Charge	£11.46 per sq ft est pa
Legal Fees	Each party to bear their own costs
EPC Rating	C (51)



Designed under the mantra 'ready to work', the 3rd floor will be delivered with a high quality landlord 'plug and play' fit out installed.

Location

7 Bishopsgate is attractively located between the arterial transport hubs of Bank and Liverpool Street, offering unrivalled connectivity between the City, the West End and wider London.

The local amenity offering is also exceptional with the established luxury retail of the Royal Exchange/Cheapside/Leadenhall Market and food and beverage offering at the Broadgate Estate, are all within a short walk.

Accommodation

The accommodation comprises the following NIA(s):

Name	sq ft	Rent	Rates Payable (sq ft)	Service Charge (sq ft)	Total month	Total year	Fitout Concept	Availability
			(34 11)	(34 11)				
3rd	7,908	£72.50 /sq ft	£23	£11.46	£70,486.64	£845,839.68	CAT B	Coming Soon
1st	7,083	£59.50 /sq ft	£23	£11.46	£55,459.89	£665,518.68	CAT B	Available E
Ground	5,813	£57.50 /sq ft	£23	£11.46	£44,546.96	£534,563.48	CAT B	Coming Soon

Terms

A flexible new FRI Lease direct from the landlord is available for a term by arrangement.







'iewing / further information

Francis Cundell


020 7029 3620 | 07939 598 545 f.cundell@inglebytrice.co.uk

Malcolm Trice


020 7029 3610 | 07791 049792 m.trice@inglebytrice.co.uk

CBRE LTD (Joint Agent)

Ingleby Trice 10 Foster Lane, London EC2V 6HR inglebytrice.co.uk +44 (0)20 7029 3610 agency@inglebytrice.co.uk

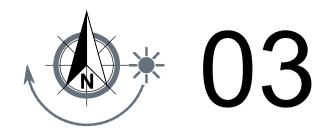

22 September 2020 10:39:10, MODUS 1-100 C.CTB, 1:100, USER1295, HUGO LOUREIRO, A:\Ambit\Projects\3031A - 7 Bishopsgate\03 Design\02.2 Drawings\02.2.4 Location LO\2020.225_LO_03_.dwg

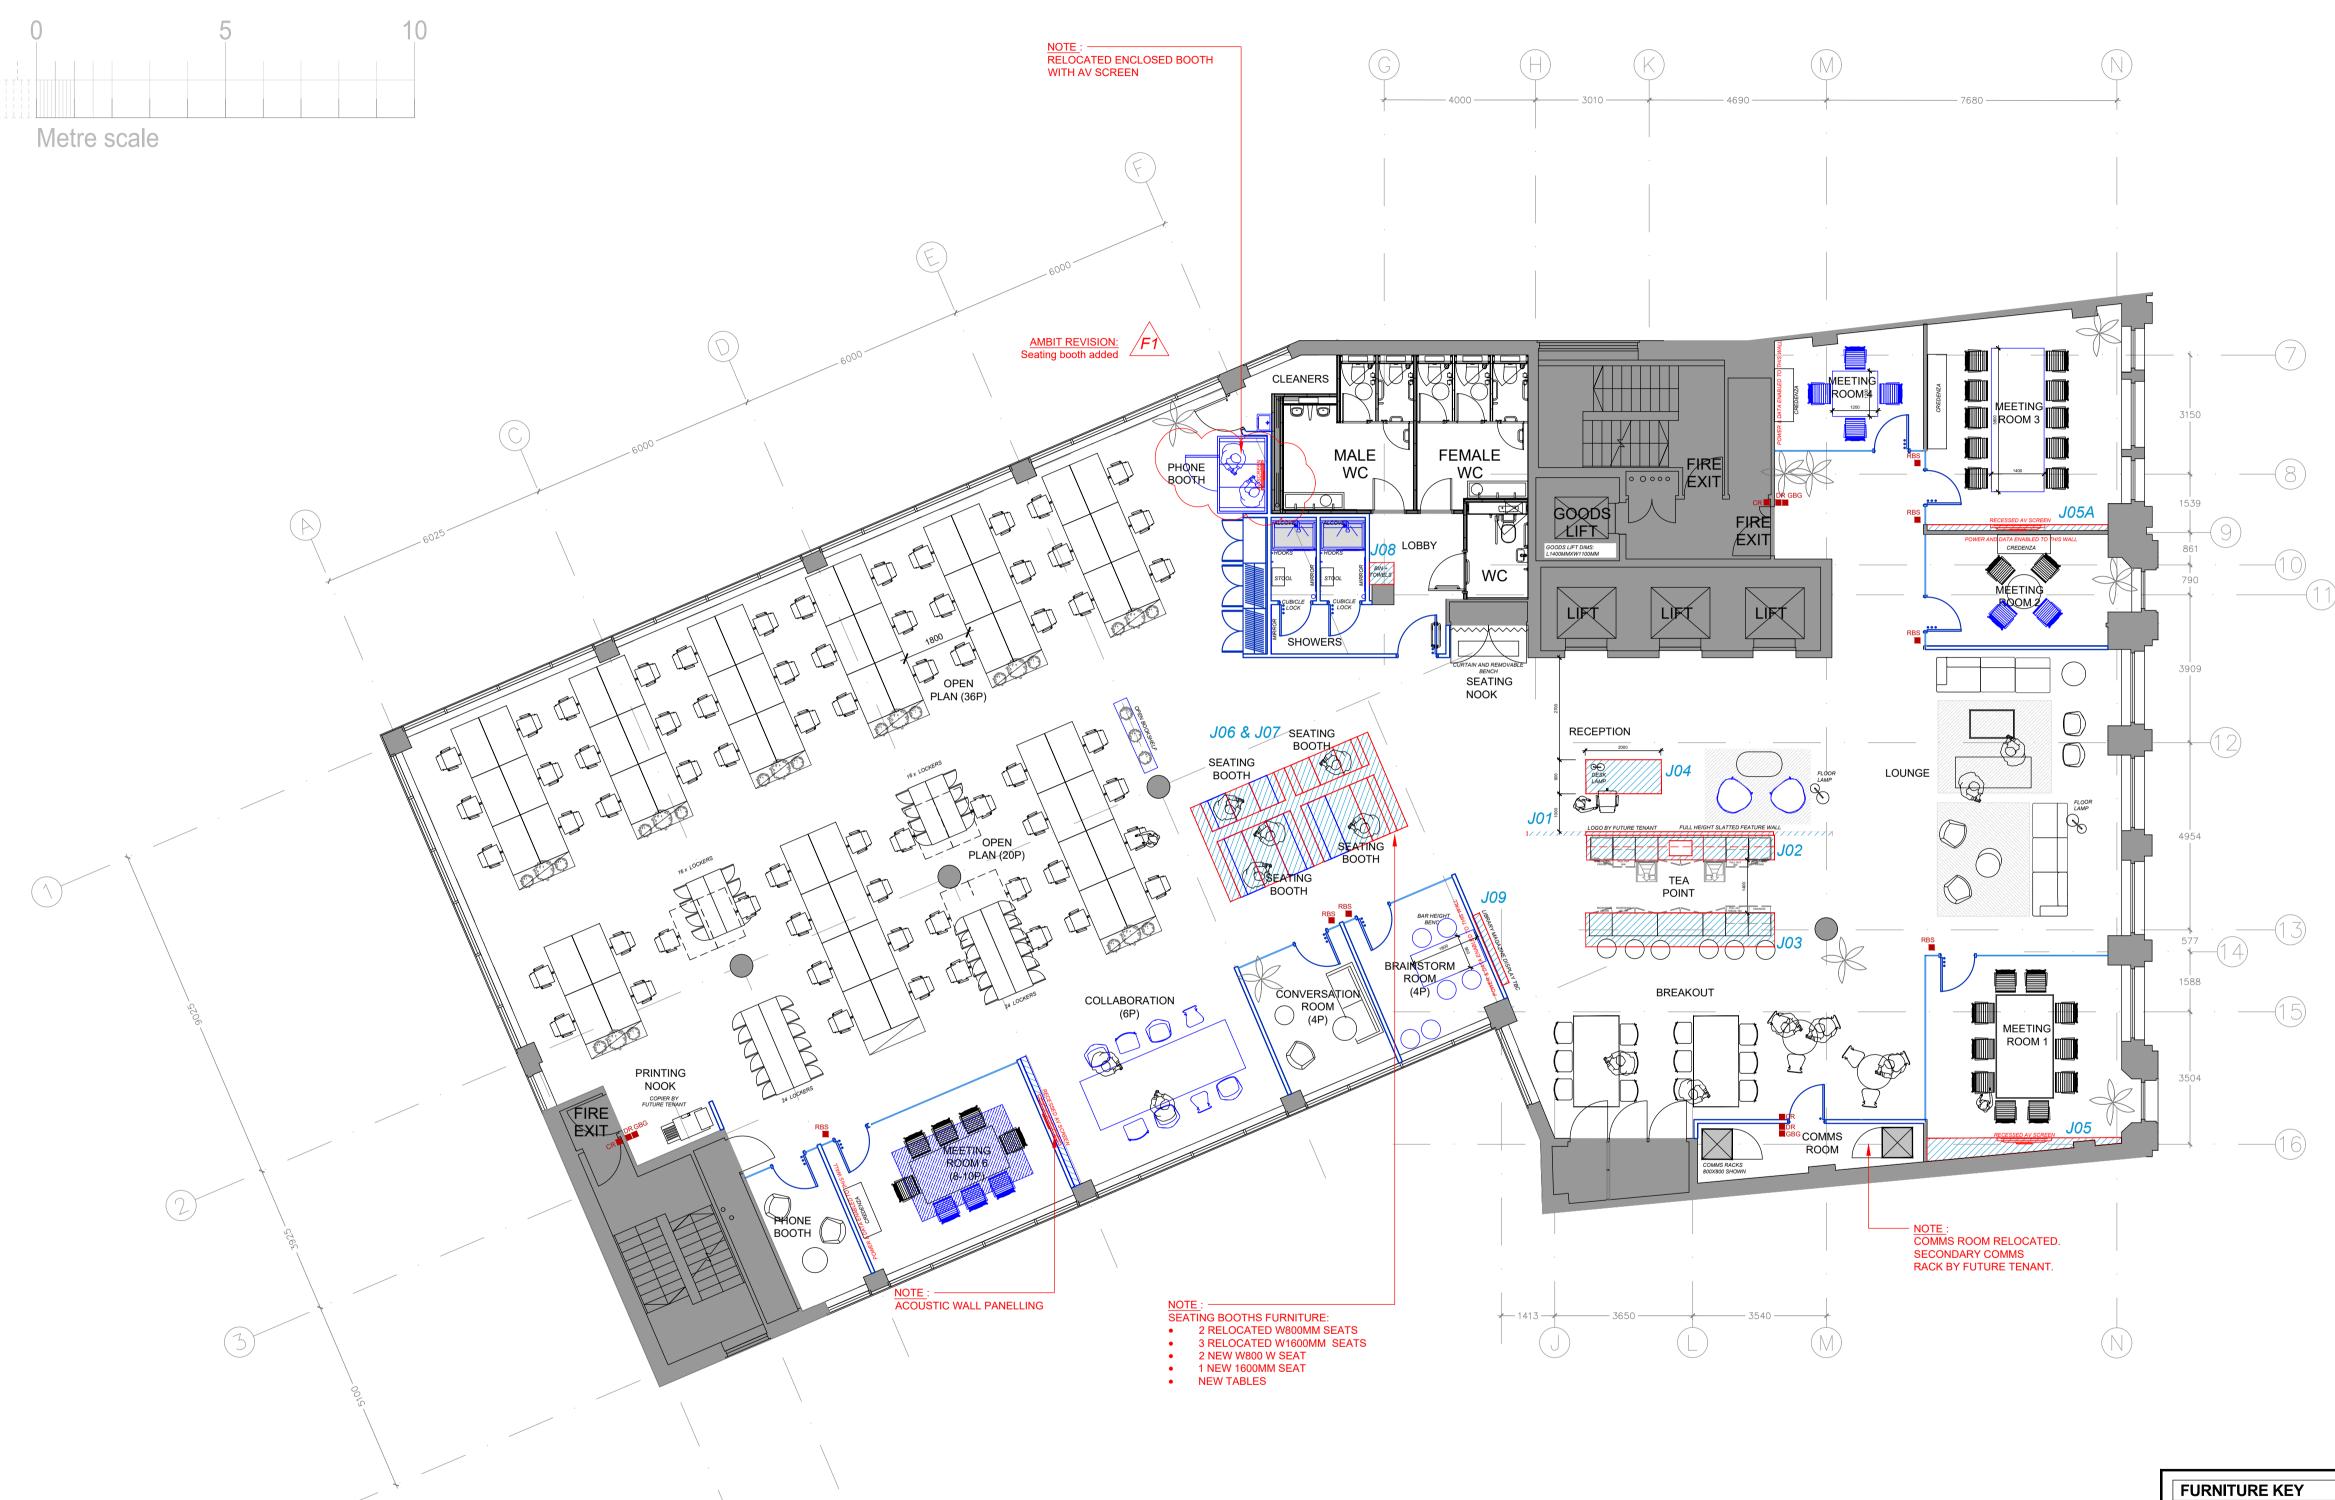

F & --- FUTURE WORKSTATIONS WORKSTATIONS EXISTING FURNITURE REFER TO CONTRACTORS DETAIL DRAWINGS MINIMAL WORKS PROPOSED IN THESE AREAS NOTES SHOWN IN RED NOTE 1: FURNITURE BY PLATFFORM & SHOWN NOTIONALLY NOTE 2: ALL PLANTS BY CLIENT

NOTES: DO NOT SCALE FROM THIS DRAWING.

THIS DRAWING REQUIRES:

CLIENT APPROVALLANDLORD APPROVAL

 BUILDING CONTROL APPROVAL FIRE OFFICER APPROVAL

REV BY DATE DESCRIPTION

K HL 22.06.20 SEATING AND PHONE BOOTHS JOINERY
REPLACED WITH FURNITURE. BREAKOUT REV

L HL 29.06.20 REVISION FOLLOWING CLIENT'S DESIGN

воотн

© COPYRIGHT WORKPLACE FUTURES GROUP 2020

SPACE PLAN KEY

FLOOR SQ.M APPROX. = 755.1sqm FLOOR SQUARE FOOT =8128sqft

Square foot shown is based on supplied building shell

and includes all columns - subject to site survey **GENERAL CEILING HEIGHT = 2700mm**

Unless other noted - Refer to survey details FLOOR VOID = TBCmm
Unless other noted - Refer to survey details

CEILING VOID = TBCmm
Unless other noted - Refer to survey details

ACCOMMODATION SCHEDULE

DESKS	QTY
Offices	0
Desks	56
Hot Desks (Seating /Phone Booths)	10
Sub Total	66
Future Growth	8
Total Desk Count	74*

FACILITIES

FACILITIES	
Reception	1
Tea Point	1
Breakout Area	1
Lounge	1
Phone Booths	2
Seating Booths	4
Small Meeting Room (Under 6P)	2
Medium Meeting Room (6P to 8P)	1
Large Meeting Room (Over 8P)	2
Brainstorm Room	1
Conversation Room	1
Collaboration	2
Comms Room	1
Store Room	1
Printing	1
Showers (New)	2
Cleaners	1
Lockers (80 Total)	1
Total Facilities	26

* MAX OCCUPANCY RECOMMENDED BY BUILDING CONTROL IS OF 76 PEOPLE AT ANY GIVEN TIME ON

Francis House 11 Francis Street London SW1P 1DE

T:+44 20 3176 1777 info@ambitmoat.com www.ambitmoat.com

FLOOR REV.

GRAFTON ADVISORS BENTALL GREEN OAK

SITE ADDRESS: 7 BISHOPSGATE CORNHILL

LONDON EC2N 3AR

3031A

PROJECT No.

DRAWN BY: 1:100@A1 HUGO LOUREIRO 18.09.2020

CONSTRUCTION

DRAWING TITLE THIRD FLOOR SPACE PLAN

SHEET NUMBER

A-101-SP-00