FLOOR SQUARE FOOT = 6,713 sqft
Square foot shown is based on supplied building shell and includes all columns - subject to site survey

GENERAL CEILING HEIGHT = 2700mm
Unless other noted - Refer to survey details

FLOOR VOID = 000mm
Unless other noted - Refer to survey details

CEILING VOID = 000mm
Unless other noted - Refer to survey details

ACCOMMODATION SCHEDULE

FACILITY	QTY
Reception	.
Open Plan (1400x800mm)	80
Boardroom (16 Person)	1
Meeting Room (4-5 Person)	5
Meeting Room (2-3 Person)	2
Open Meeting Pods	3
Breakout Area	1
Comms Room	1
Tea Point	1
Print Area	2
Storage Room	1
Lockers	80
TOTAL HEAD COUNT	**80**

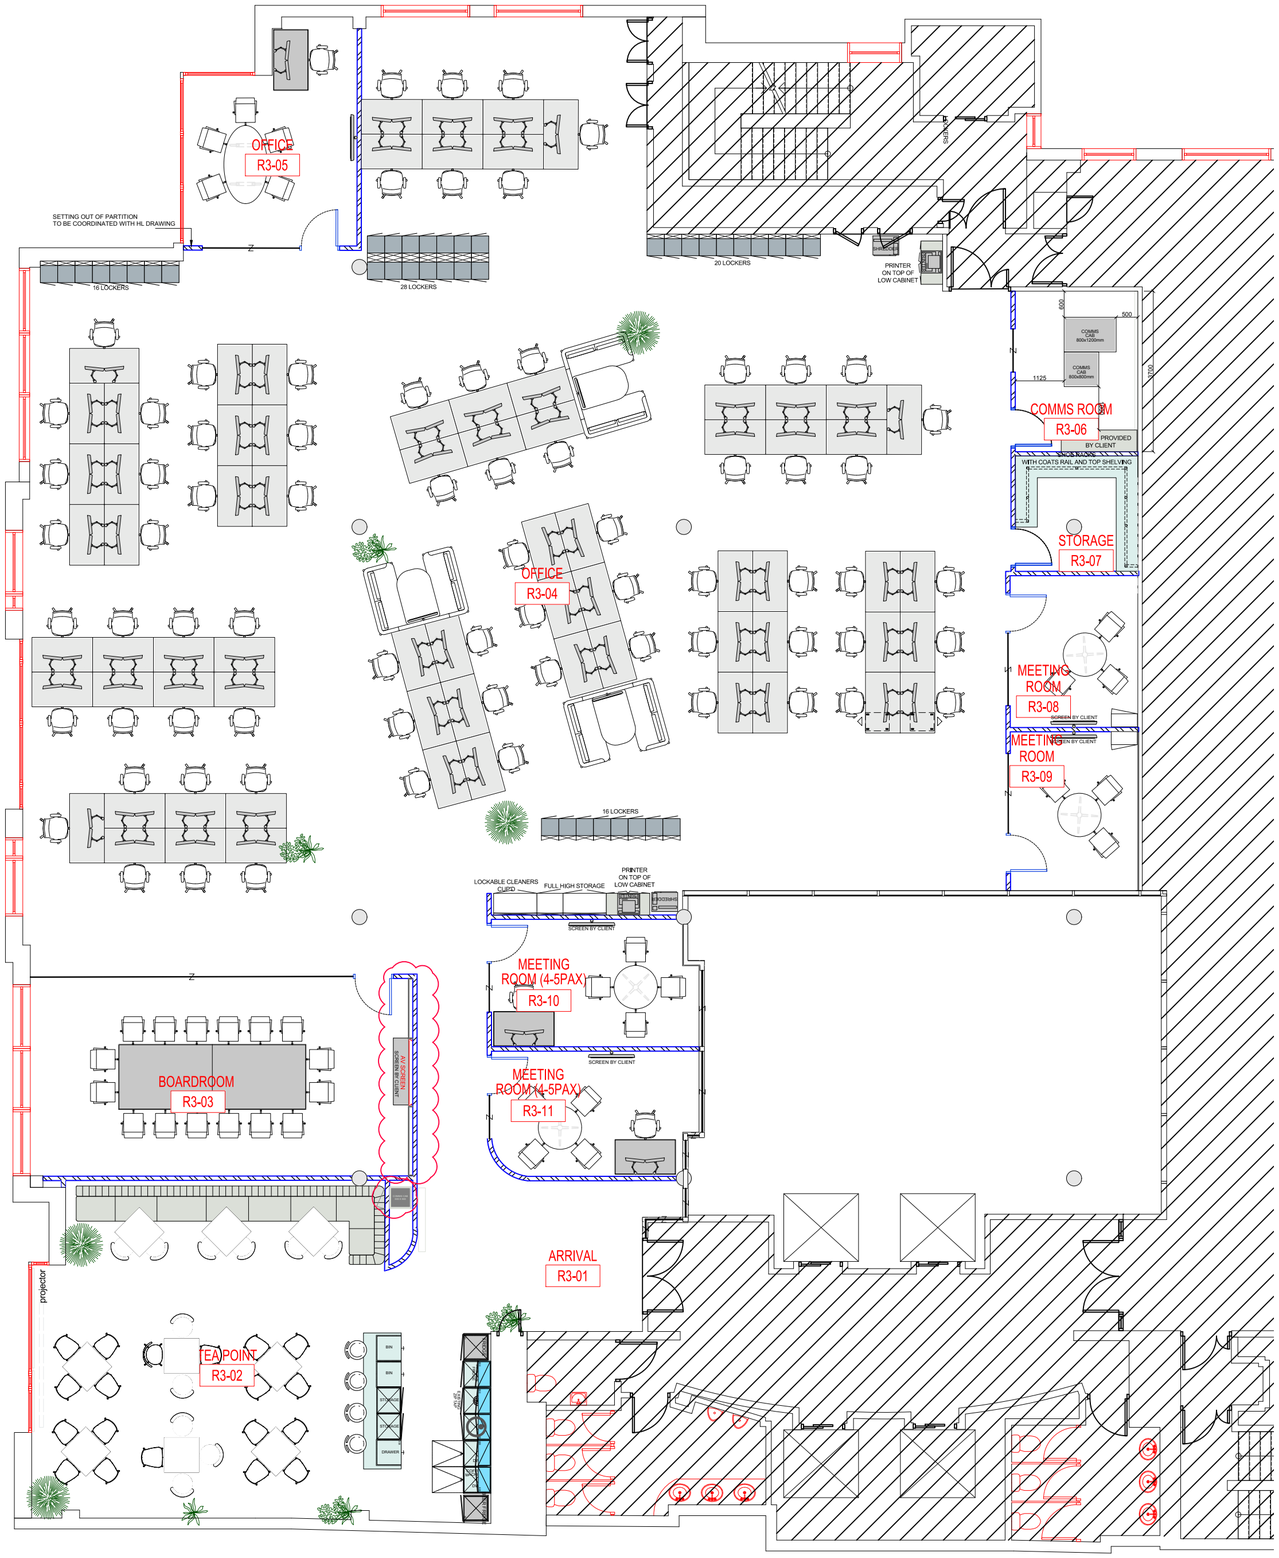

GENERAL ARRANGEMENT LEGEND

Symbols shown are not to scale
some symbols may not appear on the layout plan

WALL STYLES

- Existing structural wall
- Existing internal partition
- *New single skin partition - 75mm*
- *New single skin partition - 100mm*
- *New double skin partition - 100mm*
- *Demolished Partition*
- *New low partition*
- *New half height partition with glazing above*

PARTITION CODE DETAILS

- PARTITION RF - CS — *Raised floor to ceiling slab*
- PARTITION FS - USC — *Floor slab to underside of suspended ceiling*
- PARTITION FS - CS — *Floor slab to ceiling slab*
- SOUND BARRIER FV CV — *Sound barrier partition FV = 'In floor void' CV = 'In ceiling void'*
- FIRE BARRIER FV CV — *Fire barrier partition FV = 'In floor void' CV = 'In ceiling void'*
- PARTITION STRENGTHENING P — *Plywood partition strengthening*
- PARTITION STRENGTHENING M — *Mdf partition strengthening*

GLAZING DETAILS

- *Existing glazed module*
- *Existing silicon glass*
- *New single glazed module*
- *New double glazed module*
- *New single glazed silicon glass*
- *New double glazed silicon glass*

DOOR DETAILS

Existing door · *New Solid door* · *New Frameless glass door* · *New Framed glass door* · *New Alluminium Framed glass door* · *New Oversized Solid door*

New Special Oversized door · *New Glass Sliding Door* · *New Pivot Door*

EX1-01 EX1=Existing 1st floor · RE1-02 EX1=Relocated 1st floor
N1-05 N1=New 1st floor
V.P.= Vision panel · 01 =Door number · SEC = Security door
FD20S = Fire door rated with smoke seal
FD20S =20 min · FD30S =30 min · FD60S =60 min

GENERAL REFERENCES

R1-01 R1 = 1st floor room, 01 = Room no. · W1-01 W1 = 1st floor window, 01 = Window no.
N2-125 ND-New Furniture Ref No
E3-125 ED-Existing Furniture Ref No

Comms floor · Vinyl floor · Wood floor · Tiled floor

Existing furniture · New furniture · Joinery Item
Low height (Tambour unit) · Medium height (Drawer unit) · Full height (Door unit)
General Storagewall · Cloaks Storagewall · Roller Storage
Credenza · Racking System · Filing Cabinet
Benching / Worksurface · DDA compliant benching / worksurface · General shelving

Rev	Descriptive amendments	Drawn by	Date
AB	Issued for As Built	RH	02.05.19
I	Revised Drawing	SR	18.02.19
H	Revised Drawing	SR	08.01.19
G	Revised Drawing	SR	08.01.19
F	Revised Drawing	SR	08.01.19
E	Revised Drawing	SR	08.01.19
D	Revised Drawing	SR	08.01.19
C	Revised Drawing	SR	08.01.19
B	Revised Drawing	SR	08.01.19
A	Revised Drawing	SR	08.01.19
-	Drawing first produced	SR	08.01.19

Pre-Design - Construction - As Built
AS BUILT

Client
Client Server

Client Contact
David Kerr

Site Address
80 Cheapside, London, EC2V 6EE

Drawing Title
General Arrangement

Account Manager
Paul Millo

Designer/ Project Manager
Simona Rizzo

Scale	Drawn by	First Drawing Date
1:100 @A2	SR	09/01/2019

Contract Number	Building	Floor	Detail	Revision
5924	01	03	GA	AB

First Floor
322 High Holborn
London
WC1V 7PB
T: +44 (0)20 7553 9500
www.oktra.co.uk
oktra reach

NOTES: This drawing is the exclusive Copyright of Oktra and may not be copied or handed to any Third parties without prior consent, All dimensions must be checked on site and not scaled from the drawing, All drawings and proposals are subject to approvals by statutory authorities