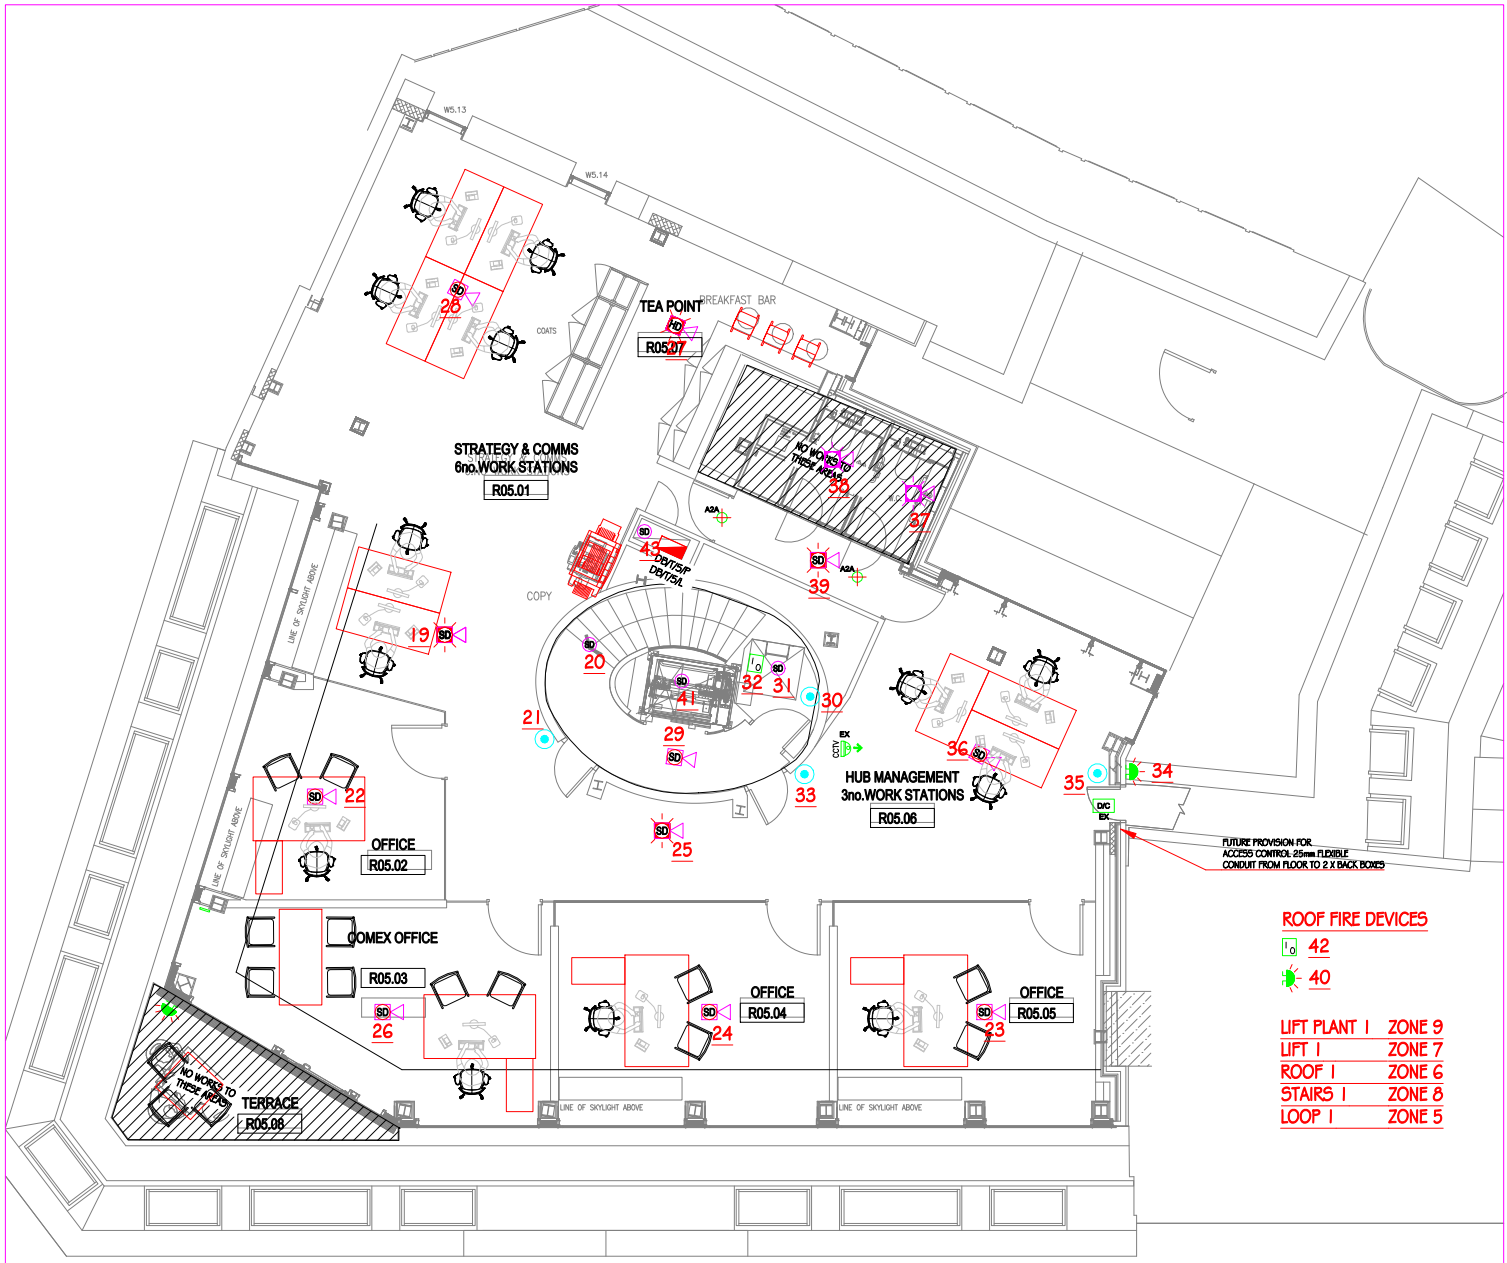

FIFTH FLOOR

LEGEND

- SD — SMOKE DETECTOR
- SD — SMOKE DETECTOR ON SOUNDER BASE
- SD — SMOKE DETECTOR ON SOUNDER BASE WITH FLASHING BEACON
- HD — HEAT DETECTOR
- HD — HEAT DETECTOR ON SOUNDER BASE
- HD — HEAT DETECTOR ON SOUNDER BASE WITH FLASHING BEACON
- MANUAL BREAK GLASS UNIT
- EXTERNAL SOUNDER / FLASHING BEACON
- INTRUDER ALARM SOUNDER / FLASHING BEACON
- DUMMY INTRUDER ALARM SOUNDER / FLASHING BEACON
- INFRARED MOVEMENT DETECTOR
- FAP — FIRE ALARM PANEL
- PSU — POWER SUPPLY UNIT
- GREEN BREAK GLASS
- EG — EGRESS BUTTON
- CR — CARD READER
- MAG — MAGLOCK
- CCTV DOME CAMERA

ROOF FIRE DEVICES

- I/O 42
- 40

LIFT PLANT 1	ZONE 9
LIFT 1	ZONE 7
ROOF 1	ZONE 6
STAIRS 1	ZONE 8
LOOP 1	ZONE 5

PLEASE REFER TO THE 'CLYMAC' BASE BUILD DRAWINGS FOR DEAILS OF EXISTING COVERAGE AND LAYOUTS TO AREAS NOT COVERED UNDER THIS CONTRACT

- CV SD — CEILING VOID DETECTOR
- I/O — INPUT OUTPUT INTERFACE UNIT
- D/C — DOOR CONTACT (INTRUDER)

Rev	Description	Date

CCE Projects Limited
Drift Road, Whitehill, HAMPSHIRE. GU35 9DZ
Tel. 01420 477773
www.cceprojects.co.uk

Project Name	ASIA HOUSE
Drawing Name	5th FLOOR FIRE & SECURITY
Drawing No	5472-5-003
Scale	1:50@A1
Drawn By	SMC
Date	17/11/15
Revision	AS INSTALLED